

October 13, 2025

ADDENDUM NO. 2

**TO THE
CONTRACT DOCUMENTS FOR
FOREMAN BUNDY REVERSE OSMOSIS WTP
WESLEY 2R WELL REHABILITATION &
CHERRY GLADE WELL CONSTRUCTION
DWI PROJECT NO.: SRP-D-134-0115
PASQUOTANK COUNTY, NORTH CAROLINA**

Bid Date: **October 17, 2025 – 11:00 A.M.**

From: **Green Engineering, P.L.L.C.
Consulting Engineers
Wilson, North Carolina**

NOTICE TO BIDDERS:

This Addendum is issued prior to the receipt of bids for the above project and **must be** acknowledged on Page 4 of 7 of the BID FORM where indicated.

The CONTRACT DOCUMENTS for this work are modified as follows:

BID FORM:

Replace Bid Form in its entirety and replace with Attachment 1. Changes include the following:

- **ARTICLE 2 – ATTACHMENTS TO THIS BID**
 - Added Individual Well Driller Experience to Paragraph 2.01 as described in Addendum No. 1.
- **ARTICLE 3 – BASIS OF BID – LUMP SUM BID AND UNIT PRICES**
 - Added Unit Price Item 9 to Paragraph 3.02.A. for 24"ϕ Black Steel Pit Casing to be used for the Cherry Glade Well Base Bid Well Section with 14"ϕ Sch 20 316L Stainless Steel Inner Casing.
 - Added Alternate Unit Price Item 10A to Paragraph 3.02.B. for 30"ϕ Black Steel Pit Casing to be used for the Cherry Glade Well Alternate Bid Well Section with 16"ϕ SDR 17 Certa-lok PVC Inner Casing.

DRAWINGS:

The following drawing is being reissued:

DRAWING SHEET 3 OF 3 – RAW WATER WELL SECTIONS:

– SECTION A/3 – CHERRY GLADE WELL BASE BID – Revised diameter of pit casing to 24-inch.

END OF ADDENDUM NO. 2

ATTACHMENT 1 – REVISED BID FORM

BID FORM FOR CONSTRUCTION CONTRACT

The terms used in this Bid with initial capital letters have the meanings stated in the Instructions to Bidders, the General Conditions, and the Supplementary Conditions.

ARTICLE 1—OWNER AND BIDDER

1.01 This Bid is submitted to:

**Pasquotank County
206 East Main Street
Elizabeth City, North Carolina 27909**

1.02 The undersigned Bidder proposes and agrees, if this Bid is accepted, to enter into an Agreement with Owner in the form included in the Bidding Documents to perform all Work as specified or indicated in the Bidding Documents for the prices and within the times indicated in this Bid and in accordance with the other terms and conditions of the Bidding Documents.

ARTICLE 2—ATTACHMENTS TO THIS BID

2.01 The following documents are submitted with and made a condition of this Bid:

- A. Required Bid security;
- B. List of Proposed Subcontractors;
- C. List of Proposed Suppliers;
- D. NC Division of Water Infrastructure MBE/WBE (DBE) Compliance Supplement – Good Faith Efforts Form (2 pages);
- E. NC Division of Water Infrastructure MBE/WBE (DBE) Compliance Supplement – Table A
- F. Individual Well Driller Experience
- G. Evidence of authority to do business in the state of the Project; or a written covenant to obtain such authority within the time for acceptance of Bids;
- H. Contractor's license number as evidence of Bidder's State Contractor's License.

ARTICLE 3—BASIS OF BID—LUMP SUM BID AND UNIT PRICES

3.01 *Lump Sum Bids*

- A. Bidder will complete the Work in accordance with the Contract Documents for the following lump sum (stipulated) price(s), together with any Unit Prices indicated in Paragraph 3.02:
 - 1. Lump Sum Price (Single Lump Sum)

Lump Sum Bids		
Item No.	Description	Bid Amount
1	Wesley 2R Well Rehabilitation: The Bidder agrees to perform all work and to furnish all labor, tools, equipment, materials and supplies for the complete rehabilitation of the existing Wesley 2R raw water gravel packed deep well as described in Specification Section 1373 and as described or implied on the Engineer's Drawings, except for any unit price bid items for this well listed below, for the lump sum price of:	\$
3	Cherry Glade Production Well Construction: The Bidder agrees to perform all work and to furnish all labor, tools, equipment, materials and supplies for the complete construction of one (1) raw water gravel packed deep well for the Cherry Glade well site as described in Specification Section 1372 and as described or implied on the Engineer's Drawings, except for any unit price bid items for the Cherry Glade well listed below, for the lump sum price of:	\$
Lump Sum Bid Price		\$

3.02 Unit Price Bids

A. Bidder will perform the following Work at the indicated unit prices:

Item No.	Description	Unit	Estimated Quantity	Bid Unit Price	Bid Amount
1	Wesley 2R Well – Pumping test setup fee (including pump installation)	EA	1		\$
2	Cherry Glade Well – Pumping test setup fee (including pump installation)	EA	1		\$
3	Wesley 2R Well – 24-hour constant rate pumping test	Hour	24		\$
4	Cherry Glade Well – 24-hour constant rate pumping test	Hour	24		\$
5	Cherry Glade Well – 22"Ø borehole	LF	435		
6	Cherry Glade Well – 14"Ø Sch 20 316L Stainless Steel Inner Casing	LF	389.05		\$
7	Cherry Glade Well – 1½"Ø Stainless Steel Level Indicator Pipe	LF	379.05		\$
8	Cherry Glade Well – Gravel Pack, Bentonite Plug, Neat Cement Grout, and Centralizers per Base Bid Well Section on Dwg. 3 of 3	LS	1		\$
9	Cherry Glade Well – 24"Ø Black Steel Pit Casing per Base Bid Well Section on Dwg. 3 of 3	LF	107.55		\$
Total of All Unit Price Bid Items					\$

B. Unit Price (Alternates)

Item No.	Description	Unit	Estimated Quantity	Bid Unit Price	Bid Amount
5A	Cherry Glade Well – 25.5"Ø borehole in lieu of 22"Ø borehole	LF	435		\$
6A	Cherry Glade Well – 16"Ø SDR 17 Certa-Lok PVC Inner Casing (Elev. 16.00' to - 338.05') in lieu of 14"Ø Sch 20 316L Stainless Steel Inner Casing for same elevations	LF	354.05		\$
7A	Cherry Glade Well – 1½"Ø Stainless Steel Level Indicator Pipe	LF	322.05		\$
8A	Cherry Glade Well – Gravel Pack, Bentonite Plug, Neat Cement Grout, and Centralizers per Alternate Bid Well Section on Dwg. 3 of 3	LS	1		\$
9A	Cherry Glade Well – Sch 20 316L Stainless Steel Reducer, 16"Ø SDR 17 Certa-Lok PVC x 14"Ø Stainless Steel	EA	1		\$
10A	Cherry Glade Well – 30"Ø Black Steel Pit Casing per Alternate Bid Well Section on Dwg. 3 of 3	LF	107.55		\$

C. Bidder acknowledges that:

- each Bid Unit Price includes an amount considered by Bidder to be adequate to cover Contractor's overhead and profit for each separately identified item, and
- estimated quantities are not guaranteed, and are solely for the purpose of comparison of Bids, and final payment for all Unit Price Work will be based on actual quantities, determined as provided in the Contract Documents.

3.03 *Total Bid Price (Lump Sum and Unit Prices)*

Total Bid Price (Total of all Lump Sum and Unit Price Bids)	\$
---	----

~~ARTICLE 4—BASIS OF BID—COST PLUS FEE~~

Deleted

~~ARTICLE 5—PRICE PLUS TIME BID~~

Deleted

ARTICLE 6—TIME OF COMPLETION

- Bidder agrees that the Work will be substantially complete and will be completed and ready for final payment in accordance with Paragraph 15.06 of the General Conditions on or before the dates or within the number of calendar days indicated in the Agreement.
- Bidder accepts the provisions of the Agreement as to liquidated damages.

ARTICLE 7—BIDDER’S ACKNOWLEDGEMENTS: ACCEPTANCE PERIOD, INSTRUCTIONS, AND RECEIPT OF ADDENDA

7.01 *Bid Acceptance Period*

- A. This Bid will remain subject to acceptance for 120 days after the Bid opening, or for such longer period of time that Bidder may agree to in writing upon request of Owner.

7.02 *Instructions to Bidders*

- A. Bidder accepts all of the terms and conditions of the Instructions to Bidders, including without limitation those dealing with the disposition of Bid security.

7.03 *Receipt of Addenda*

- A. Bidder hereby acknowledges receipt of the following Addenda:

Addendum Number	Addendum Date

ARTICLE 8—BIDDER’S REPRESENTATIONS AND CERTIFICATIONS

8.01 *Bidder’s Representations*

- A. In submitting this Bid, Bidder represents the following:
1. Bidder has examined and carefully studied the Bidding Documents, including Addenda.
 2. Bidder has visited the Site, conducted a thorough visual examination of the Site and adjacent areas, and become familiar with the general, local, and Site conditions that may affect cost, progress, and performance of the Work.
 3. Bidder is familiar with all Laws and Regulations that may affect cost, progress, and performance of the Work.
 4. Bidder has carefully studied the reports of explorations and tests of subsurface conditions at or adjacent to the Site and the drawings of physical conditions relating to existing surface or subsurface structures at the Site that have been identified in the Supplementary Conditions, with respect to the Technical Data in such reports and drawings.
 5. Bidder has carefully studied the reports and drawings relating to Hazardous Environmental Conditions, if any, at or adjacent to the Site that have been identified in the Supplementary Conditions, with respect to Technical Data in such reports and drawings.
 6. Bidder has considered the information known to Bidder itself; information commonly known to contractors doing business in the locality of the Site; information and observations obtained from visits to the Site; the Bidding Documents; and the Technical Data identified in the Supplementary Conditions or by definition, with respect to the effect of such information, observations, and Technical Data on (a) the cost, progress, and performance of the Work; (b) the means, methods, techniques, sequences, and

procedures of construction to be employed by Bidder, if selected as Contractor; and
(c) Bidder's (Contractor's) safety precautions and programs.

7. Based on the information and observations referred to in the preceding paragraph, Bidder agrees that no further examinations, investigations, explorations, tests, studies, or data are necessary for the performance of the Work at the Contract Price, within the Contract Times, and in accordance with the other terms and conditions of the Contract.
8. Bidder is aware of the general nature of work to be performed by Owner and others at the Site that relates to the Work as indicated in the Bidding Documents.
9. Bidder has given Engineer written notice of all conflicts, errors, ambiguities, or discrepancies that Bidder has discovered in the Bidding Documents, and of discrepancies between Site conditions and the Contract Documents, and the written resolution thereof by Engineer is acceptable to Contractor.
10. The Bidding Documents are generally sufficient to indicate and convey understanding of all terms and conditions for performance and furnishing of the Work.
11. The submission of this Bid constitutes an incontrovertible representation by Bidder that without exception the Bid and all prices in the Bid are premised upon performing and furnishing the Work required by the Bidding Documents.

8.02 *Bidder's Certifications*

A. The Bidder certifies the following:

1. This Bid is genuine and not made in the interest of or on behalf of any undisclosed individual or entity and is not submitted in conformity with any collusive agreement or rules of any group, association, organization, or corporation.
2. Bidder has not directly or indirectly induced or solicited any other Bidder to submit a false or sham Bid.
3. Bidder has not solicited or induced any individual or entity to refrain from bidding.
4. Bidder has not engaged in corrupt, fraudulent, collusive, or coercive practices in competing for the Contract. For the purposes of this Paragraph 8.02.A:
 - a. Corrupt practice means the offering, giving, receiving, or soliciting of anything of value likely to influence the action of a public official in the bidding process.
 - b. Fraudulent practice means an intentional misrepresentation of facts made (a) to influence the bidding process to the detriment of Owner, (b) to establish bid prices at artificial non-competitive levels, or (c) to deprive Owner of the benefits of free and open competition.
 - c. Collusive practice means a scheme or arrangement between two or more Bidders, with or without the knowledge of Owner, a purpose of which is to establish bid prices at artificial, non-competitive levels.
 - d. Coercive practice means harming or threatening to harm, directly or indirectly, persons or their property to influence their participation in the bidding process or affect the execution of the Contract.

PASQUOTANK COUNTY
FOREMAN BUNDY REVERSE OSMOSIS WTP
WESLEY 2R WELL REHABILITATION & CHERRY GLADE WELL CONSTRUCTION
DWI PROJECT NO.: SRP-D-134-0115
LIST OF PROPOSED SUBCONTRACTORS & SUPPLIERS
(To be submitted with Bid)

PROPOSED SUBCONTRACTORS:

PROPOSED MAJOR SUPPLIERS:

BIDDER hereby submits this Bid as set forth above:

Bidder:

(typed or printed name of organization)

By:

(individual's signature)

Name:

(typed or printed)

Title:

(typed or printed)

Date:

(typed or printed)

If Bidder is a corporation, a partnership, or a joint venture, attach evidence of authority to sign.

Attest:

(individual's signature)

Name:

(typed or printed)

Title:

(typed or printed)

Date:

(typed or printed)

Address for giving notices:

Bidder's Contact:

Name:

(typed or printed)

Title:

(typed or printed)

Phone:




Email:

Address:


Bidder's Contractor License No.: (if applicable)

NOTES:

1. FINAL SCREEN SLOT SIZE AND GRAVEL PACK FOR THE CHERRY GLADE WELL TO BE DETERMINED BASED ON DRILLING CONDITIONS AND WILL BE SELECTED BY THE HYDROGEOLOGIST.
2. PROTECT 90 DEGREE ELBOW FOR STAINLESS STEEL LEVEL INDICATOR PIPE DURING INSTALLATION OF INNER CASING.

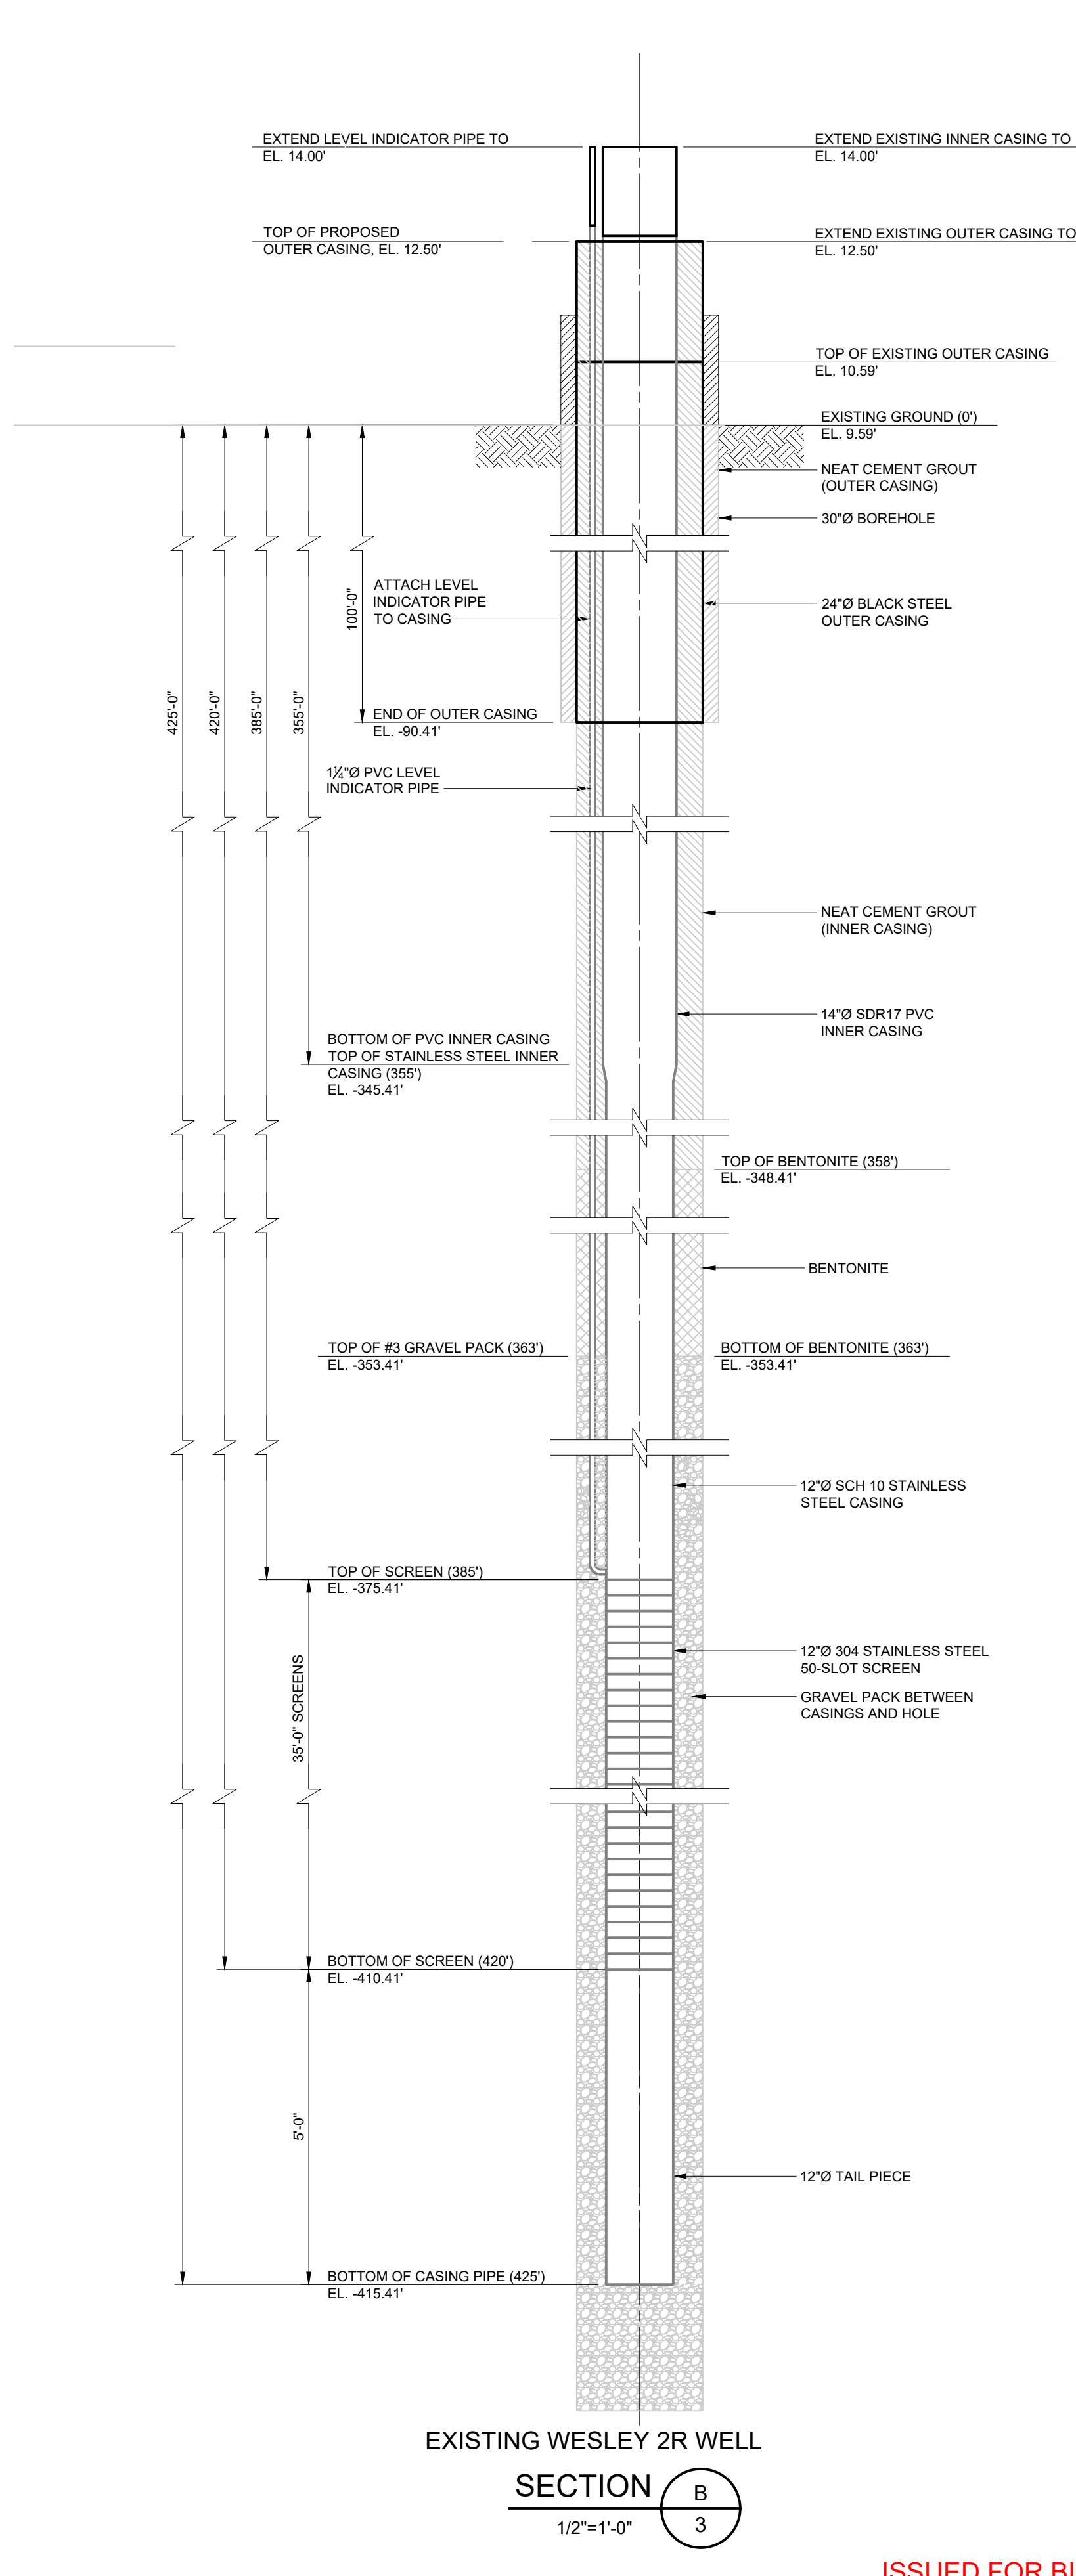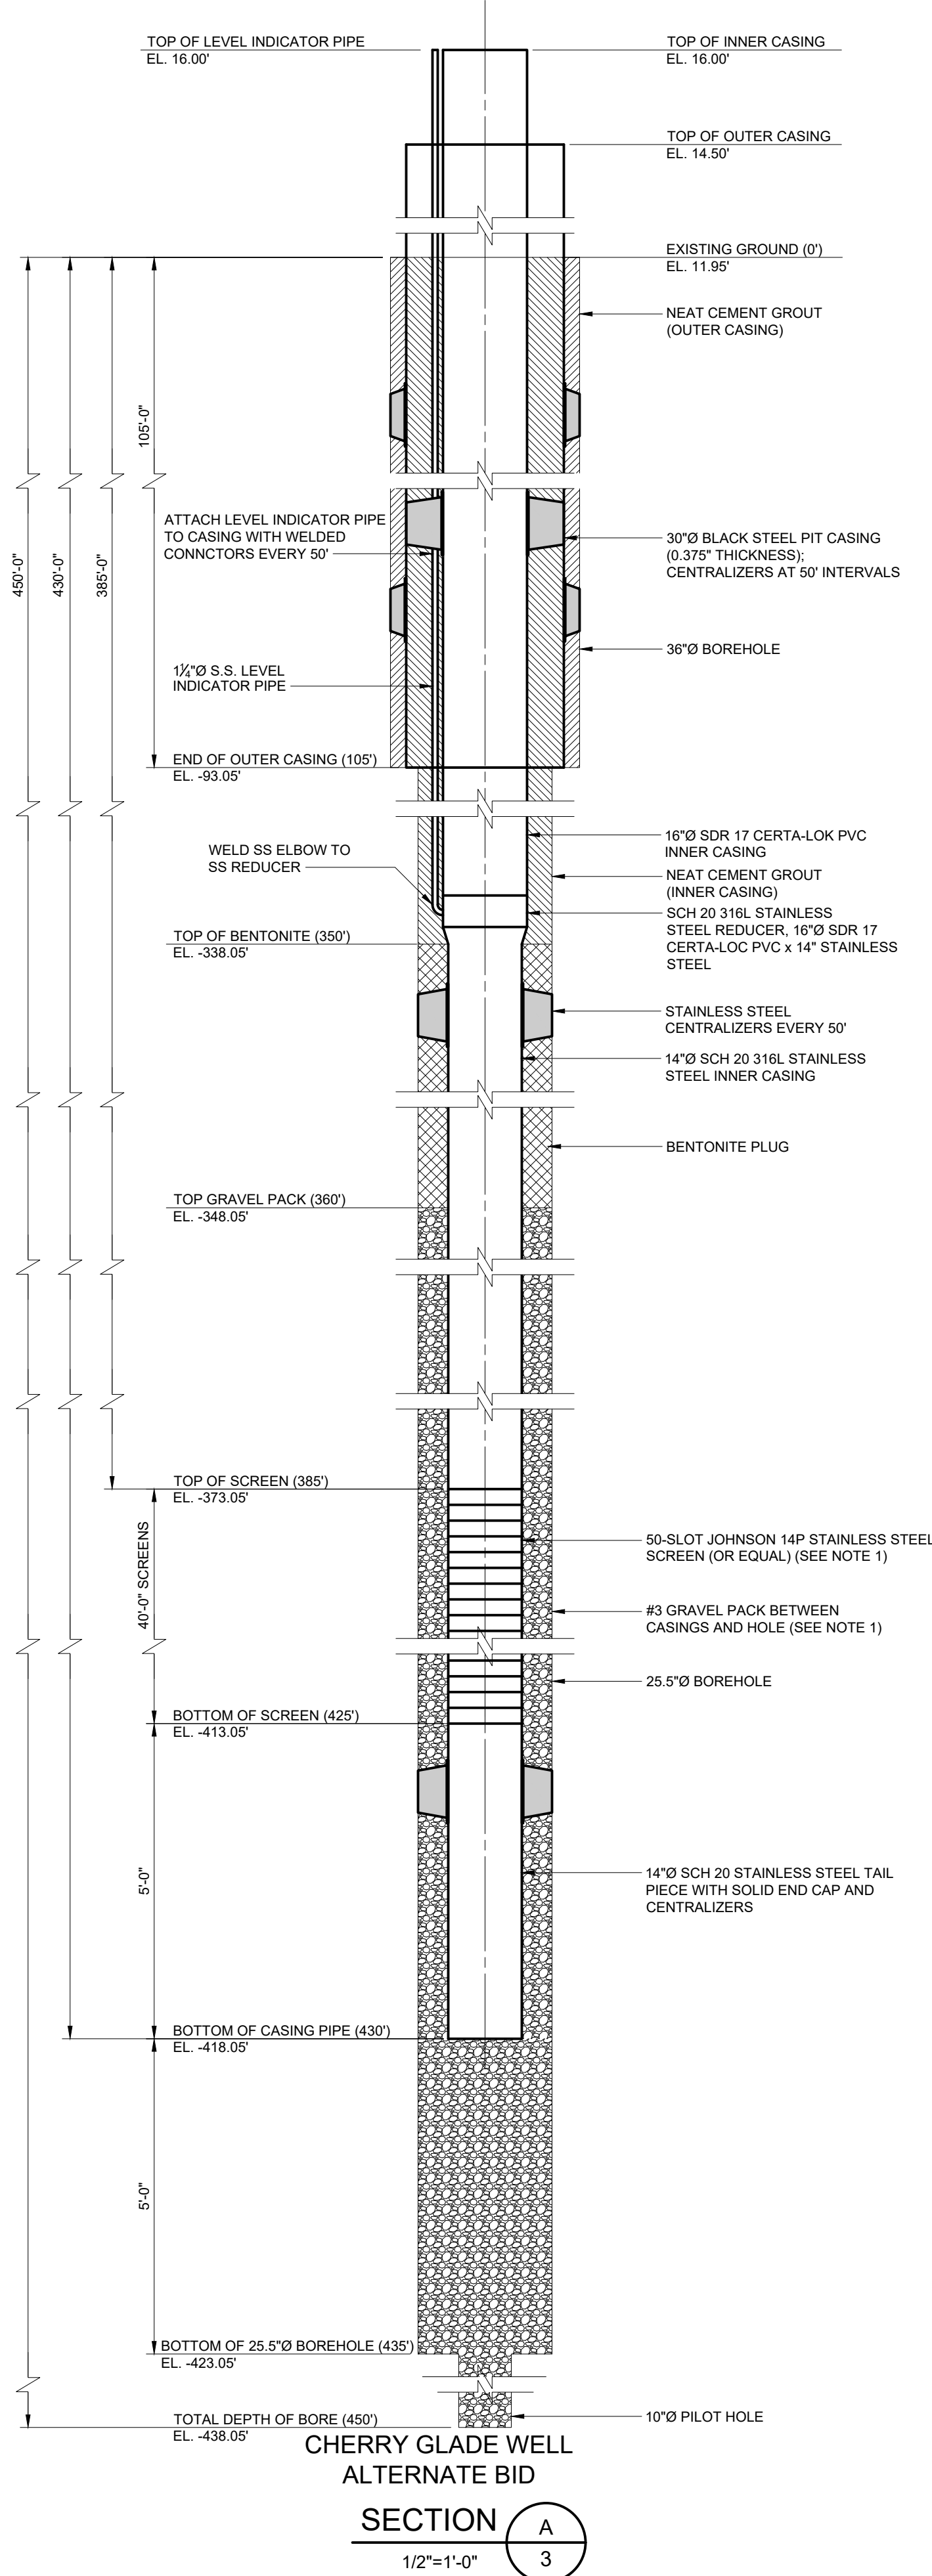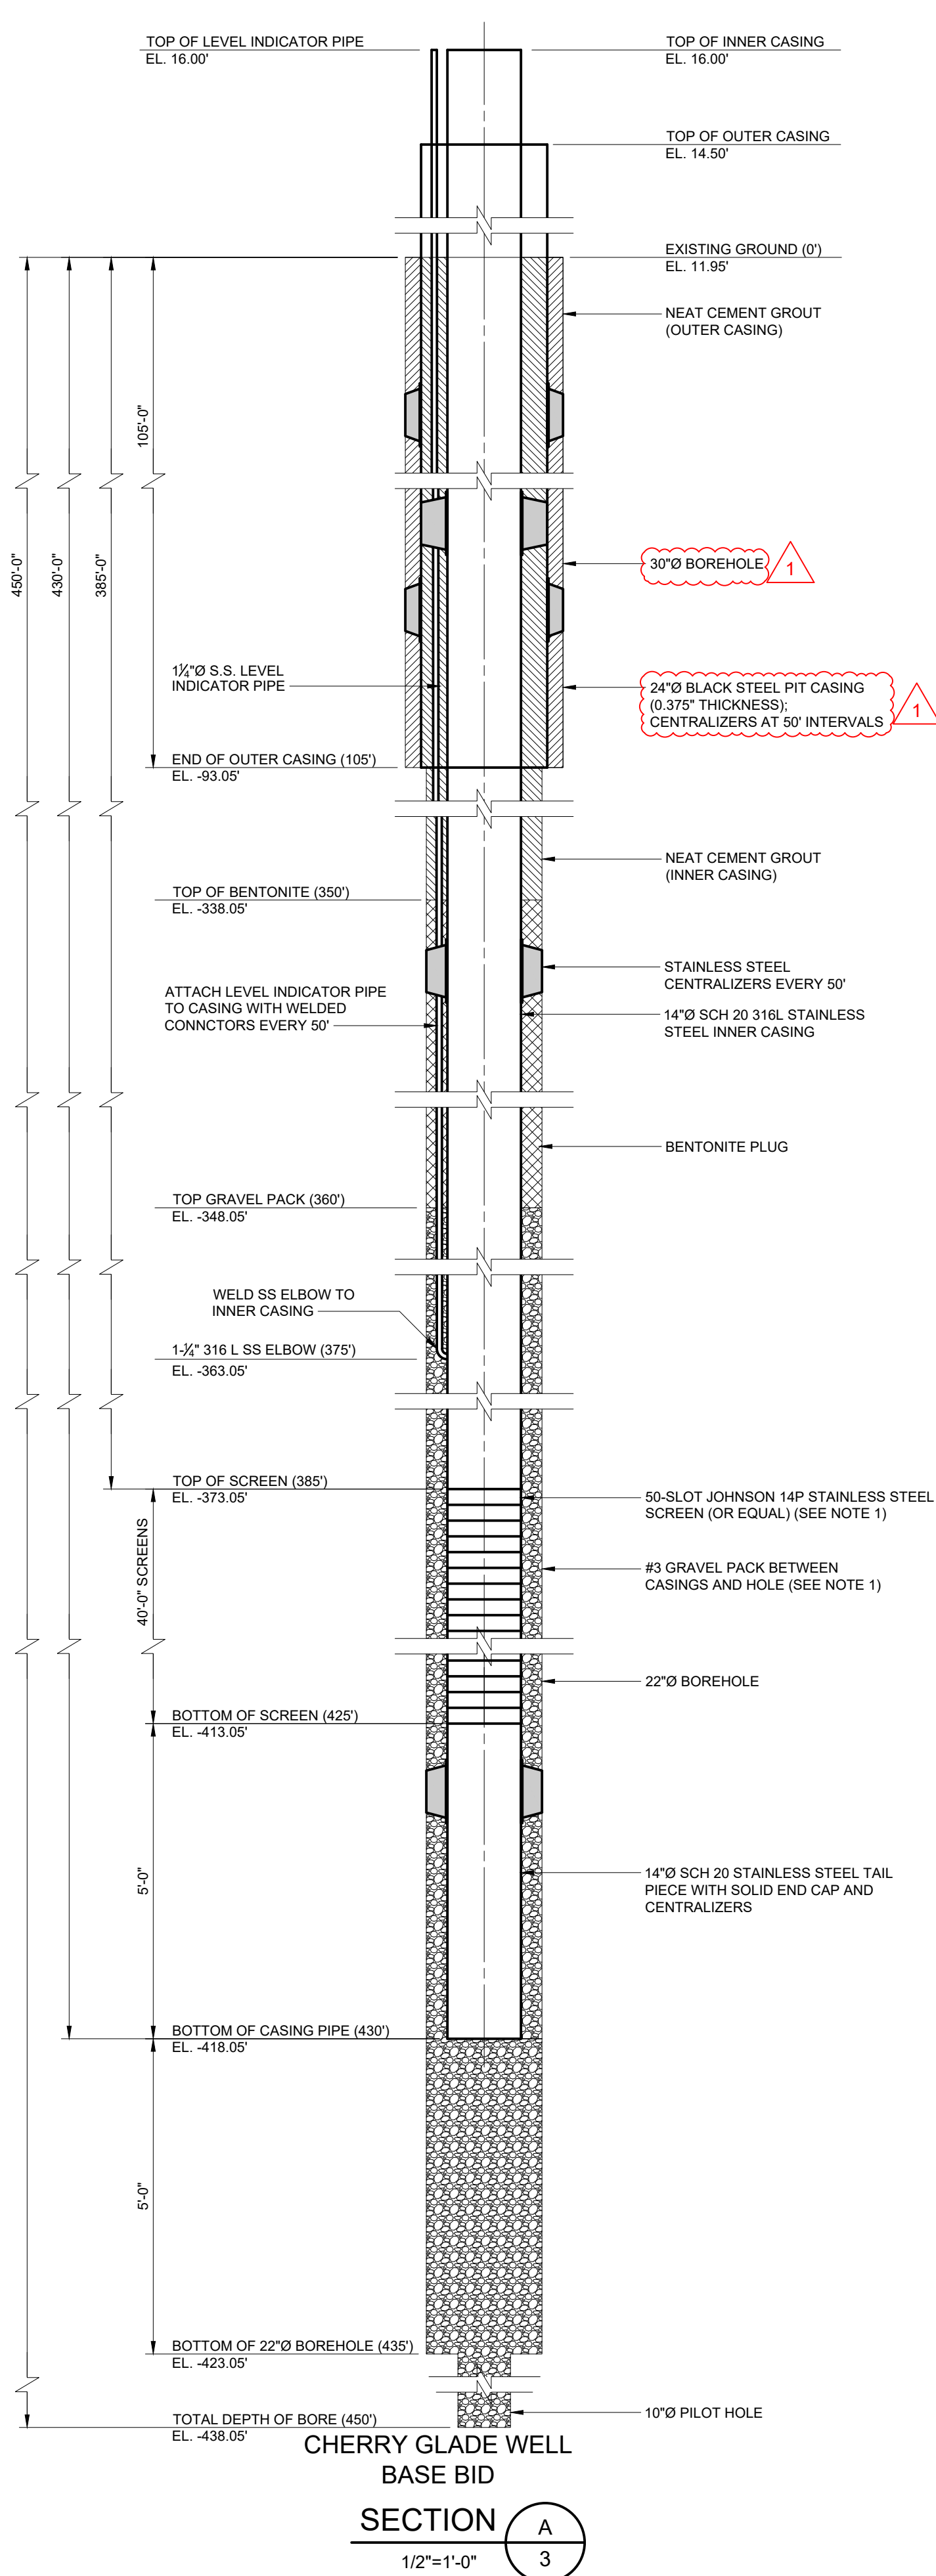

W:\PASQ\21083\CAD\WELLS\Phase 1\Addendum No. 2\21-083-WELLS1.dwg Last Plotted by: TOM DIENES for Green Engineering on Monday, October 13, 2025 @ 10:15:10 AM

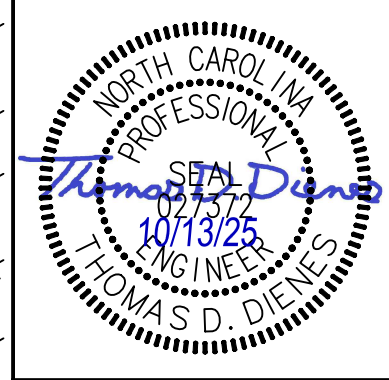

GREEN ENGINEERING
WATER, WASTEWATER, SURVEYING, PLANNING, PROJECT MANAGEMENT
NORTH CAROLINA FIRM LICENSE: P-0115
303 GOLDSBORO STREET EAST, P.O. BOX 609 WILSON, N.C. 27893
TEL (252) 237-5365 FAX (252) 243-7489 OFFICE@GREENENG.COM

PASQUOTANK COUNTY
FOREMAN BUNDY REVERSE OSMOSIS WTP
WESLEY 2R WELL REHABILITATION & CHERRY GLADE WELL CONSTRUCTION
PASQUOTANK COUNTY
NORTH CAROLINA

RAW WATER WELL SECTIONS

REVISION	DATE	BY	DATE: SEPTEMBER 2025	CLIENT CODE: PASQU
1. ADDENDUM NO. 2	10/13/25	TD		JOB NUMBER: 21-083
				FIELD BOOK: XXX
				CADFILE: 21-083-WELLS1.dwg
				ASCII FILE: Oct 13, 2025
				LAST MODIFIED: TDD
				SHEET NO. 3 OF 3